



Santa Clara

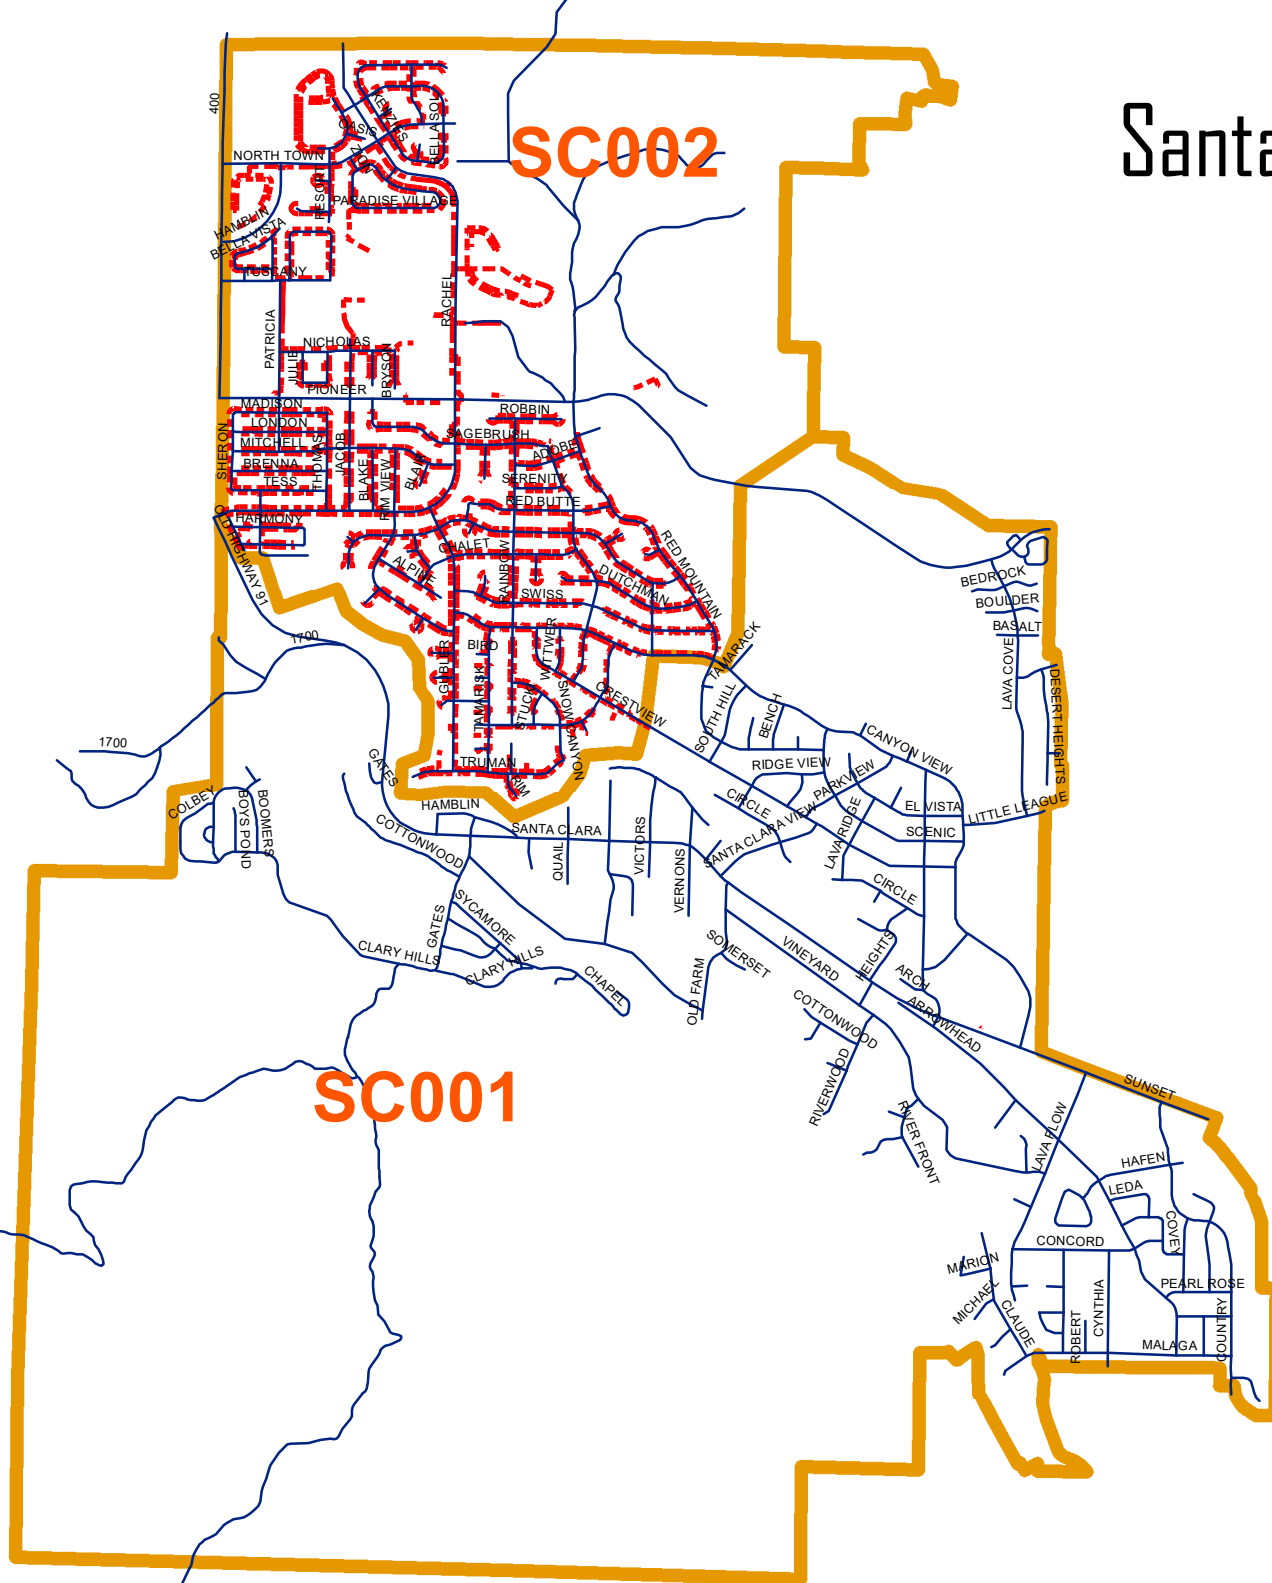

Legend

- Roads
- ACCESS_LEVEL**
- Subtype Code, STATUS**
- ASBUILT UG
- NOT ASBUILT UG
- NETWORK_FOOTPRINTS

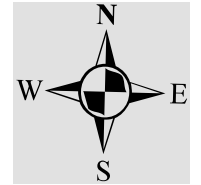